


**PIN ASSIGNMENTS:**  
 0 HBRIDGE-IN2  
 1 HBRIDGE-IN1  
 2 SCL  
 3 SDA  
 6 OneWire (DS18B20)

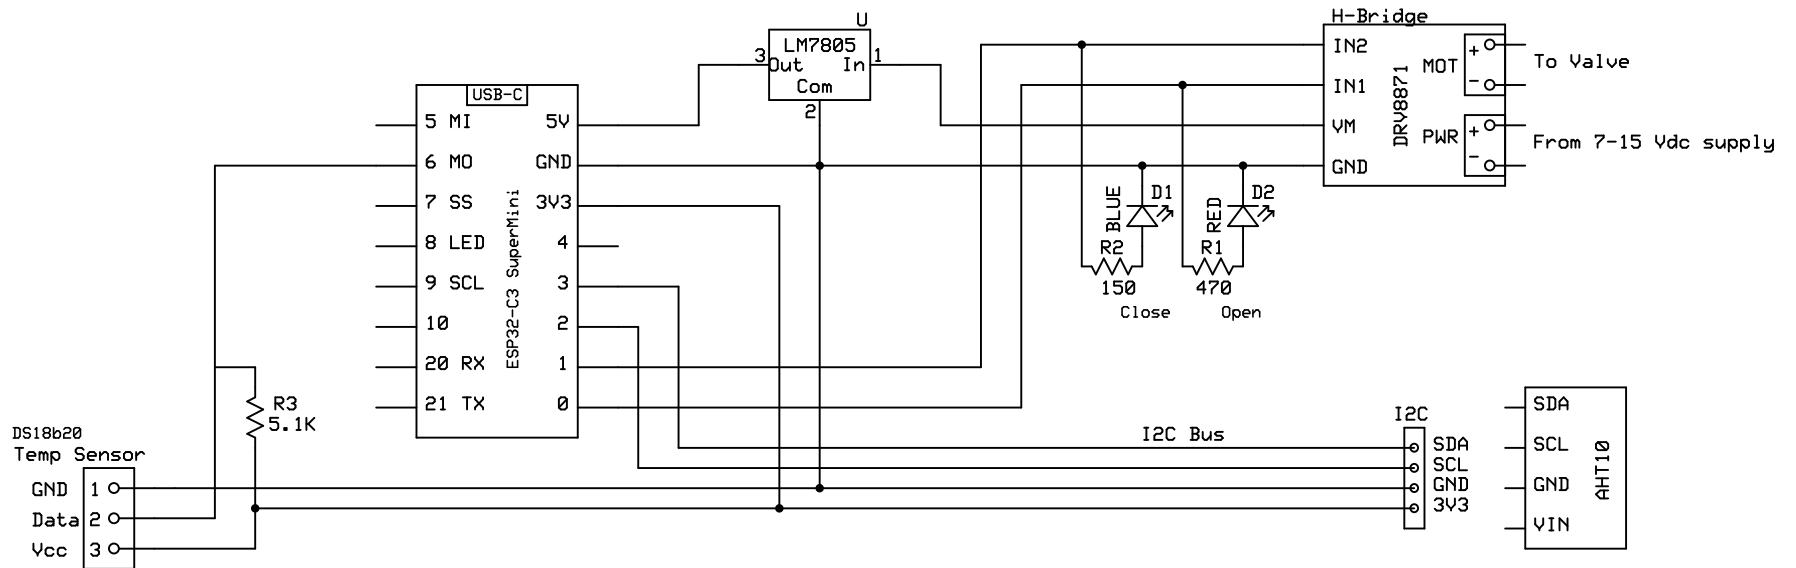

**As Built 12/30/2025**

W4KRL		
Gas Log Controller		
K. W. Berger	Rev 1.1	Page # or name
	01/01/2026	